


TABLE A - TAPER LENGTHS									
Taper Types (m)	Regulatory Speed Limit before Work Begins (km/h)								
	≤ 50	60	70	80	90	100	110	120	
Merge Taper Length	1/4	35	55	160	190	210	230	250	280
Lane Shift Taper Length	1/4	30	50	80	100	110	120	130	140
Downstream Taper Length	1/4	30	30	30	30	30	30	30	30
TCP, Signal, and Shoulder Taper Length (min. 5 devices)	1/4	5	8	15	15	15	15	15	15
Minimum Tangent Length between Tapers	1/4	30	60	160	190	210	230	250	280
Run-in Length on Centreline	1/4	40	50	60	60	70	80	90	100

TABLE B - DEVICE SPACING LENGTHS									
Device Spacing (m)	Regulatory Speed Limit before Work Begins (km/h)								
	≤ 50	60	70	80	90	100	110	120	
Construction Sign Spacing	A	40	60	80	100	150	150	200	200
Buffer Space	B	30	40	60	80	110	140	170	200
Channelizing Device Spacing for Tapers	C	10	10	15	15	15	15	15	15
Channelizing Device Spacing on Curves and Tangents	D	10	10	30	30	40	40	40	50

LEGEND	
○ Flexible Drum	Paint Truck
● Tubular Marker	Escort Truck
● Cone	Chaser Vehicle
Sign	Vehicle Mounted Rear Crash Attenuator
Person	Traffic Control Person
Flashing Light	Work Activity Area
Work Truck	360° Flashing Light
Shadow Vehicle	Portable Traffic Signal
Shadow Vehicle #1	Barricade and Fencing
Shadow Vehicle #2	Flashing Arrow Board (FAB)
Shadow Vehicle #2	Flashing Arrow Board (FAB) in caution mode
Buffer Vehicle	Dynamic Message Sign (DMS)

CONTACT INFORMATION:
 DEAN HERBERT
 604-690-3678

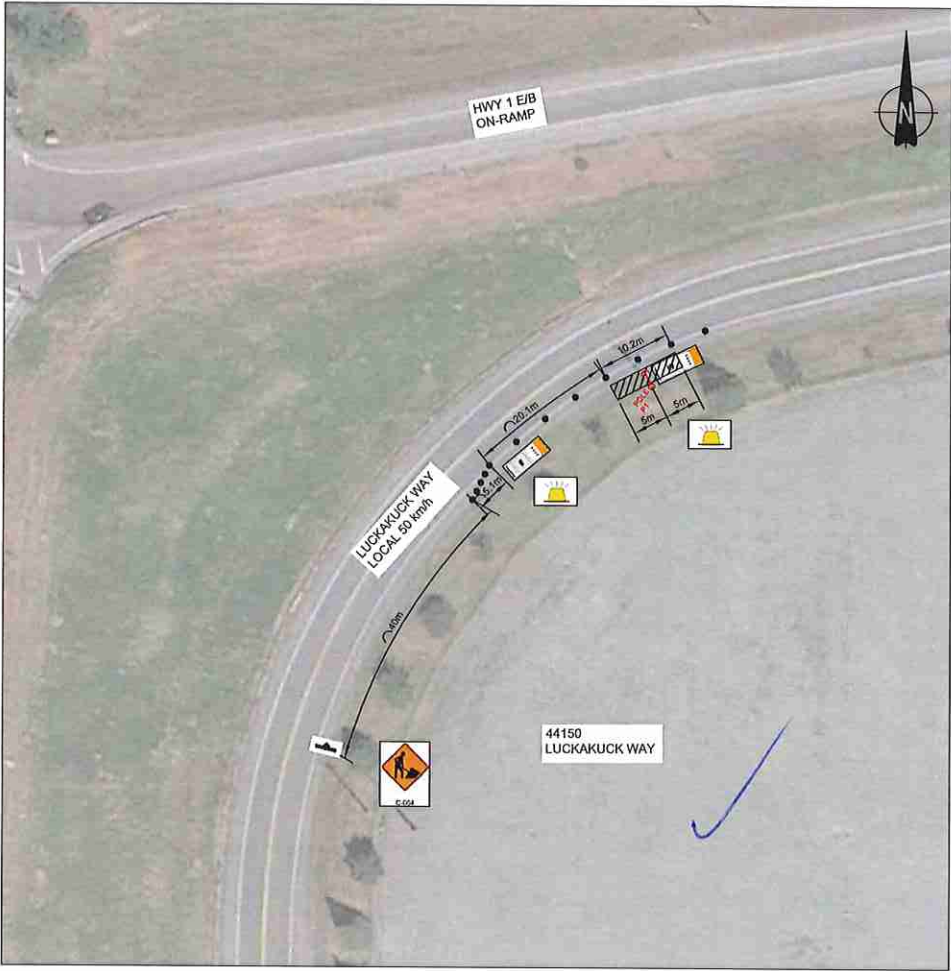

- NOTES:
1. THE WORK REQUIRING THIS TRAFFIC CONTROL MEASURE INVOLVES THE INSTALLATION OF PLATE ANCHOR & #8 DOWNGUY AT POLE P1. THIS MEASURE IS IN EFFECT UNTIL THE WORKS ARE COMPLETED.
 2. LOCATION OF THE WORK ZONE ARE AS INDICATED ON THIS PLAN FOR CONSTRUCTION. NO LANE CLOSURES ARE REQUIRED.
 3. THE MEASURES SHOWN IN THIS TRAFFIC MANAGEMENT PLAN ARE IN ACCORDANCE TO THE "BC TRAFFIC MANAGEMENT MANUAL FOR WORK ON ROADWAYS (2015 INTERIM)". CHANGES AND ADJUSTMENTS TO THIS LAYOUT TO BE MADE BY THE TRAFFIC CONTROL PERSON IN CHARGE TO REFLECT FIELD CONDITIONS.
 4. PRIORITY ACCESS WILL BE GIVEN TO EMERGENCY VEHICLES.
 5. ALL DIMENSIONS ARE IN METRES.



BC ONE CALL
 CALL BEFORE YOU DIG
 1 800-474-6886
 VANCOUVER AREA
 604-237-1940



CONSTRUCTION	PERMIT	DESIGN: CH1	DPL: DPL1
REV. DESCRIPTION	SUBMITTED DATE:	6/15/2018	SCALE: NTS
REV. DESCRIPTION	REV. SUB DATE:		DATE: 10/23/18
REV. DESCRIPTION	REV. SUB DATE:		ASSOCIATED DRAWINGS
REV. DESCRIPTION	APPROVED:	1.	
REV. DESCRIPTION	DATE:	2.	
REV. DESCRIPTION	AS CONSTRUCTED DATE:	3.	
REV. DESCRIPTION	CONTRACTOR:	REF:	

THE WORKER/PROFESSOR ON THIS DRAWING SHALL AT ALL TIMES REMAIN THE PROPERTY OF TELUS
PROPOSED GENERAL TRAFFIC CONTROL LAYOUT TO ACCOMMODATE POLE ANCHOR INSTALLATION
 WEST OF 44150 LUCKAKUCK WAY
 CHELSEA, BC
 SYSTEM NAME:
 2682051 TCP
SHEET 1