

4110297832



Nearest Intersection: Elwood Dr and Spruce Dr.
Distance from lot to Intersection is 61 meters (68 degrees South of West).
View Scale: 1:1000

7130 Elwood Dr, Chilliwack
Order #: 30997978 Prem #: 259027 City Limits: Chilliwack
X: 1294465506.00 Y: 465670922.00 2018/04/30


ATTENTION: DO NOT RELY ON THIS INFORMATION ALONE. You must manually dig to locate gas lines before using excavation machinery. All locations are shown approximate only & gas lines built after the date below are not in this information package. FortisBC will not accept responsibility for errors or omissions. Depth of gas line are not available due to possible change of grade.

MAIN ADDRESS SERVED 7130 Elwood Dr DISTRICT Sardis TYPE OF PREMISES SFD
 SERVICE SIZE 1/2" "SERVED OFF 2" " MAIN ON ELWOOD DR. TAP SIZE 5/16"
 STEEL PLASTIC TRUNK _____ PSIG HIGH MEDIUM

| | | | |
|------------------------|-----------|------------------------------|---|
| MAIN CORROSION | | YES <input type="checkbox"/> | NO <input checked="" type="checkbox"/> |
| SERVICE PIPE | | MATERIAL | |
| MAIN TO P.L. | <u>10</u> | KIT # | <u>1A</u> |
| VERTICAL FTGE (IF ANY) | | INCLUDES CURB COCK | YES <input type="checkbox"/> NO <input checked="" type="checkbox"/> |
| P.L. TO BLDG | <u>32</u> | INCLUDES MAG ANODE | YES <input type="checkbox"/> NO <input checked="" type="checkbox"/> |
| EXTENDED | <u>3</u> | WEIGHT _____ | LBS. |
| RISER | <u>3</u> | GREASER CURB COCK | |
| TOTAL | <u>48</u> | LOCATION | <u>4</u> FT. |
| SCRAP | | <u>0/5</u> | P.L. (I/S OR O/S) |

METER PROTECTION INSTALLED _____ POSTS
 METER CAGE INSTALLED: YES NO
 OLD SERVICE CUT OFF: YES NO
 CUT AT MAIN OTHER _____
 METER(S) # PAB. 80489 (DG 228557)
 INSTALLED REMOVED OUTSIDE I/S
 READING 0000

INSPECTION RPT: I HEREBY CERTIFY THAT THE PIPING WAS INSTALLED IN ACCORDANCE WITH AUTHORITY STANDARD PRACTICES AND WAS EXAMINED UNDER AN AIR TEST OF 110 PSIG. FOR 10 MINS. AND THAT NO LEAKAGE WAS INDICATED.
 DAY 1 MONTH MAY YEAR 2018
 FOREMAN [Signature] SUPVR. [Signature]
 AUTH. CRAW CONTRACTOR
 FURTHER WORK REQUIRED YES NO

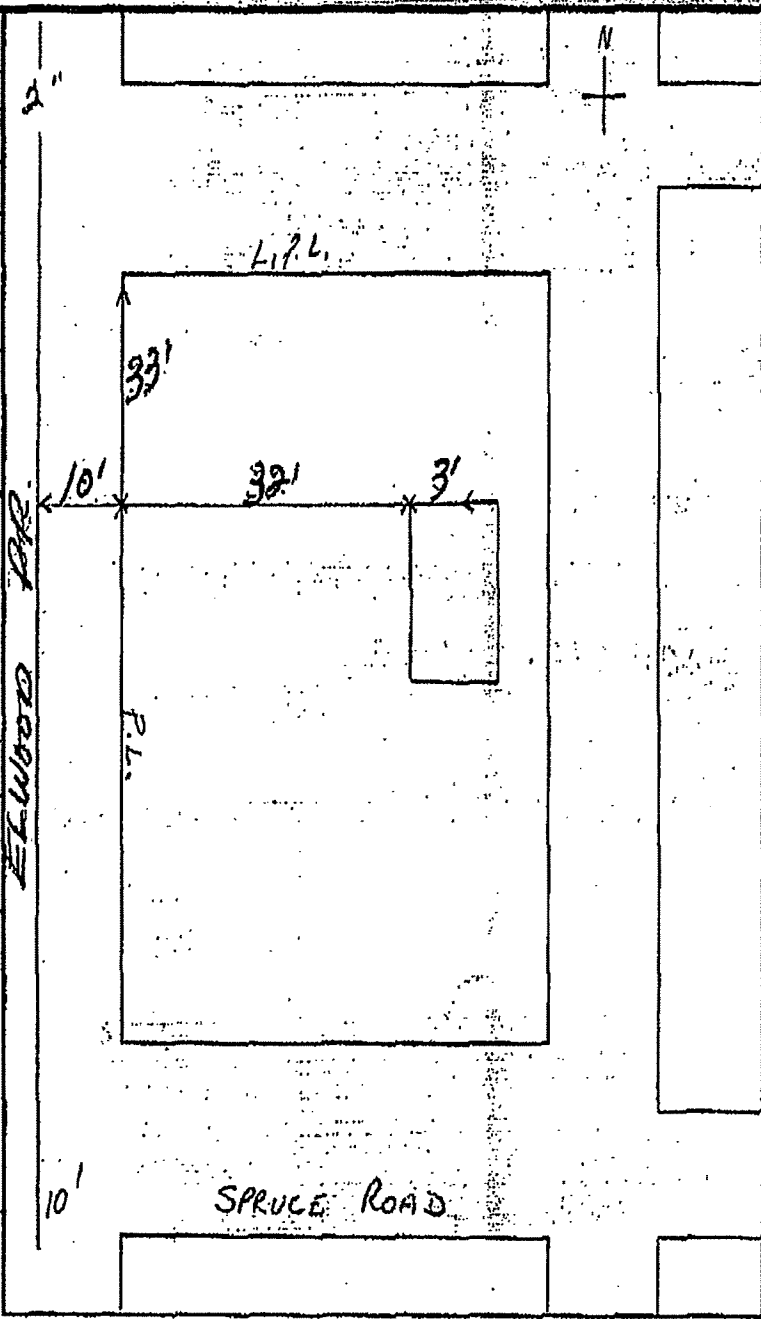

EXPLAIN: _____ PAVEMENT CUT: YES NO