



PLANNER SKETCH 4110299021  
6850 CENTENNIAL DRIVE, CHILLIWACK  
(INSTALL FROM COLLINS DRIVE)



INSTALL 14 KPA 200  
SERIES METER ON  
RHS OF SHOP.  
INSTALL 28M X  
26MM PE LONG  
SIDE SERVICE.


ATTENTION: DO NOT RELY ON THIS INFORMATION ALONE. You must manually dig to locate gas lines before using excavation machinery. All locations are shown approximate only & gas lines built after the date below are not in this information package. FortisBC will not accept responsibility for errors or omissions. Depth of gas line are not available due to possible change of grade.

MAIN ADDRESS SERVED: 6850 Centennial Dr DISTRICT: 6850 TYPE OF PREMISES: old  
 SERVICE SIZE: 1/2" "SERVED OFF" 3/4" MAIN ON: CENTENNIAL DR TAP SIZE: 5/16"

MAIN CORROSION YES  NO   
 SERVICE PIPE MATERIAL  
 MAIN TO P.L. 8' KIT # 1A  
 VERTICAL FTGE (IF ANY) INCLUDES CURB COCK YES  NO   
 P.L. TO BLOC 28' INCLUDES MAG ANODE YES  NO   
 EXTENDED 3' WEIGHT \_\_\_\_\_ LBS.  
 RISER 3' DRESSER/CURB COCK  
 TOTAL 42' LOCATION 1 FT.  
 SCRAP 0.5' P.L. (US OR O/S)

METER PROTECTION INSTALLED \_\_\_\_\_ POSTS  
 METER CAGE INSTALLED: YES  NO   
 OLD SERVICE CUT OFF: YES  NO   
 CUT AT MAIN  OTHER   
 METER(S) # 116.11562 #1790  
 INSTALLED  REMOVED  OUTSIDE  I/S   
 READING 9768

INSPECTION RPT: I HEREBY CERTIFY THAT THE PIPING WAS INSTALLED IN ACCORDANCE WITH AUTHORITY STANDARD PRACTICES AND WAS EXAMINED UNDER AN AIR TEST OF 110 PSIG, FOR 10 MINS. AND THAT NO LEAKAGE WAS INDICATED.  
 DAY 26 MONTH NOV YEAR 17  
 FOREMAN: [Signature] SUPVR: [Signature]  
 AUTH. CREW  CONTRACTOR   
 FURTHER WORK REQUIRED YES  NO

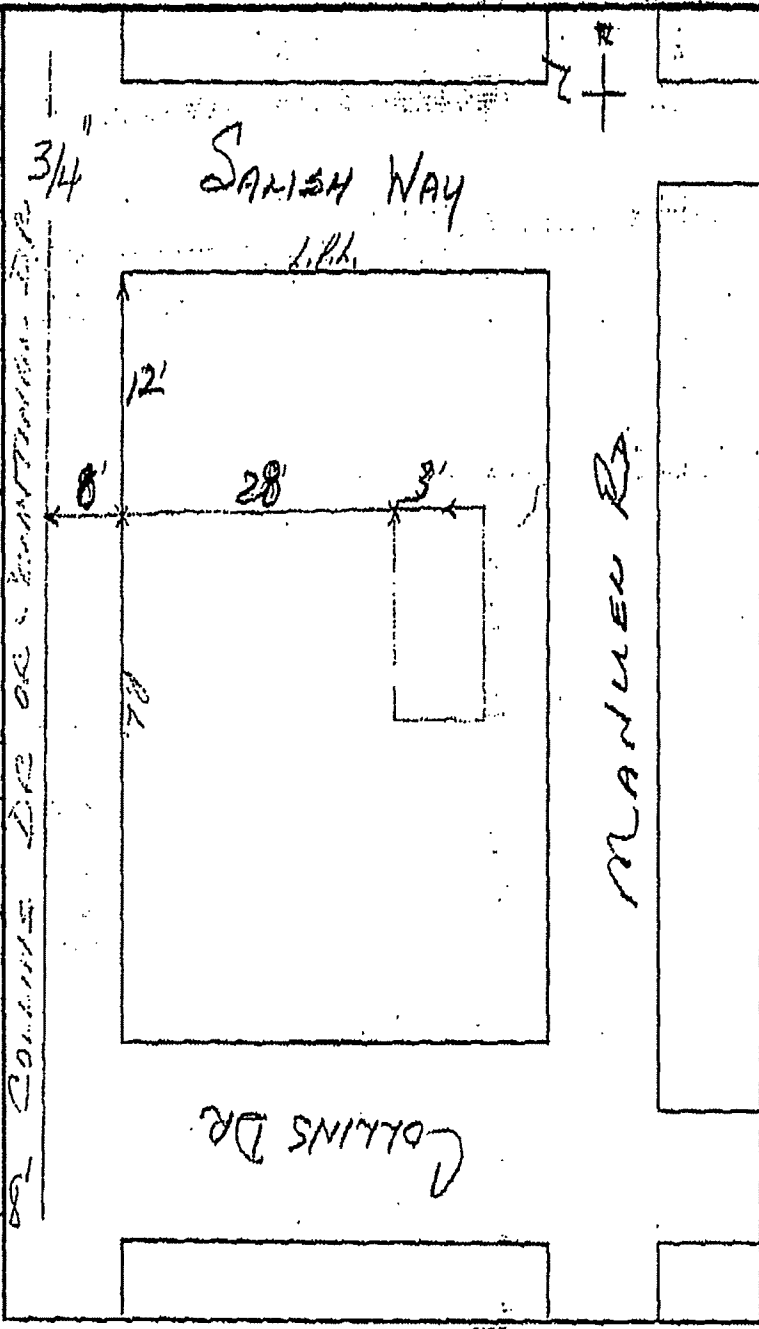

EXPLAIN: IN: RAZ 122073 @ 02-10-26 PAVEMENT CUT: YES  NO   
mcs 219790