
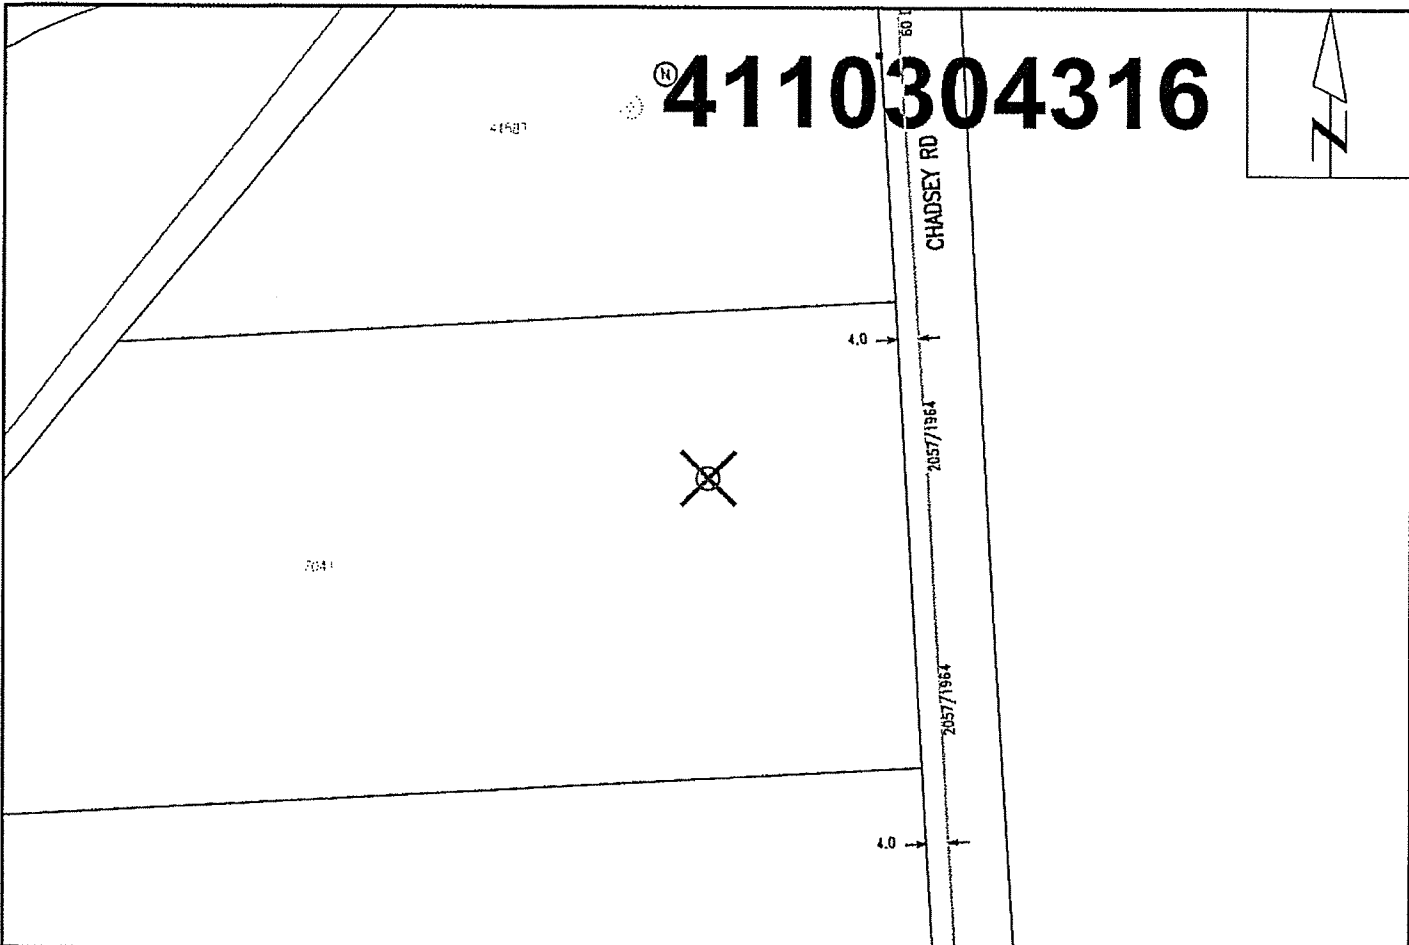


4110304316

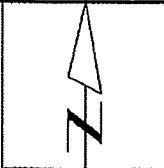

Nearest Intersection: Chadsey Rd and Yale Rd.
Distance from lot to Intersection is 118 meters (70 degrees North of East).
View Scale: 1:1000

7041 Chadsey Rd, Chilliwack
Order #: 31012495 Prem #: 278983 City Limits: Chilliwack

X: 1286711912.00 Y: 464969241.00 2018/07/16

7041 CHADSEY ROAD CHILLIWACK

7/16/2018 2:17:01 PM

ATTENTION: DO NOT RELY ON THIS INFORMATION ALONE. You must manually dig to locate gas lines before using excavation machinery. All locations are shown approximate only & gas lines built after the date below are not in this information package. FortisBC will not accept responsibility for errors or omissions. Depth of gasline are not available due to possible change of grade.

SERVICE ADDRESS: 7041- Chadsey Rd, Surrey
 DATE COMPLETED: Jan 29, 2014

SIZE: 12" LOCATED 76 FT. S. FROM N.E. CORNER OF 1.P.L.
 ON: CHADSEY RD. MAIN SIZE: 2" FEET OUT: 13" SIDE DI.

TYPE OF MAIN: STEEL
 DEPTH: 3'
 CONDITION: Good
 INSPECTION REPORT: I hereby certify that the piping was installed in accordance with Company standard practices and was examined under an air test of 5 P.S.I.G. for 5 mins. and that no leakage was indicated.

DATE: Jan 29, 2014
 SUPERVISOR: M. M. ...
 SHUT-OFF TEE: YES NO

NUMBER OF PREFAB METER SETS: 1 (9837)
 5-15-3813 (0000) T26806814 27-01-19
 OLD YARD RD.

