

4110303085



Nearest Intersection: Broadway and Fraser Ave.
 Distance from lot to intersection is 31 meters (42 degrees South of West).
 View Scale: 1:1000

9518 Broadway St, Chilliwack
 Order #: 31009951 Prem #: 304422 City Limits: Chilliwack
 X: 1296543858.00 Y: 470576616.00
 2018/08/29

ATTENTION: DO NOT RELY ON THIS INFORMATION ALONE. You must manually dig to locate gas lines before using excavation machinery. All locations are shown approximate only & gas lines built after the date below are not in this information package. FortisBC will not accept responsibility for errors or omissions. Depth of gas line are not available due to possible change of grade.

SERVICE ADDRESS: 9518 Broadway St.
 DISTRICT: Chilliwack TRUNK HIGH LOW PLATE MAP NO. 111
 TYPE OF PREMISES: SFD
 SIZE: 1/2" LOCATED 35' FT. W FROM E CORNER OF PL
 ON Fraser St.

TYPE OF MAIN: STEEL CAST GALV.
 DEPTH: 4'

SERVICE PIPE	MATERIAL
OUTSIDE P/L <u>6'</u>	KIT NO. <u>1</u>
INSIDE P/L <u>29'</u>	
RISER <u>3'</u>	INCLUDES CURB COCK YES <input type="checkbox"/> NO <input checked="" type="checkbox"/>
TOTAL <u>38'</u>	INCLUDES SHUT OFF TEE YES <input type="checkbox"/> NO <input checked="" type="checkbox"/>

STANDARD SERVICE
 IF NON-STANDARD, EXPLAIN _____


METER NUMBERS: S 602 HC-21674

INSTALLED REMOVED
 OUTSIDE INSIDE

INSPECTION REPORT: I HEREBY CERTIFY THAT THE PIPING WAS INSTALLED IN ACCORDANCE WITH AUTHORITY STANDARD PRACTICES AND WAS EXAMINED UNDER AN AIR TEST OF 10 P.S.I.G. FOR 2 MINS. AND THAT NO LEAKAGE WAS INDICATED.


DATE: Aug 4-66
 GANG S/F MAN: J. Kasan
 SUPERVISOR: J. Kasan

CORROSION
 YES
 NO

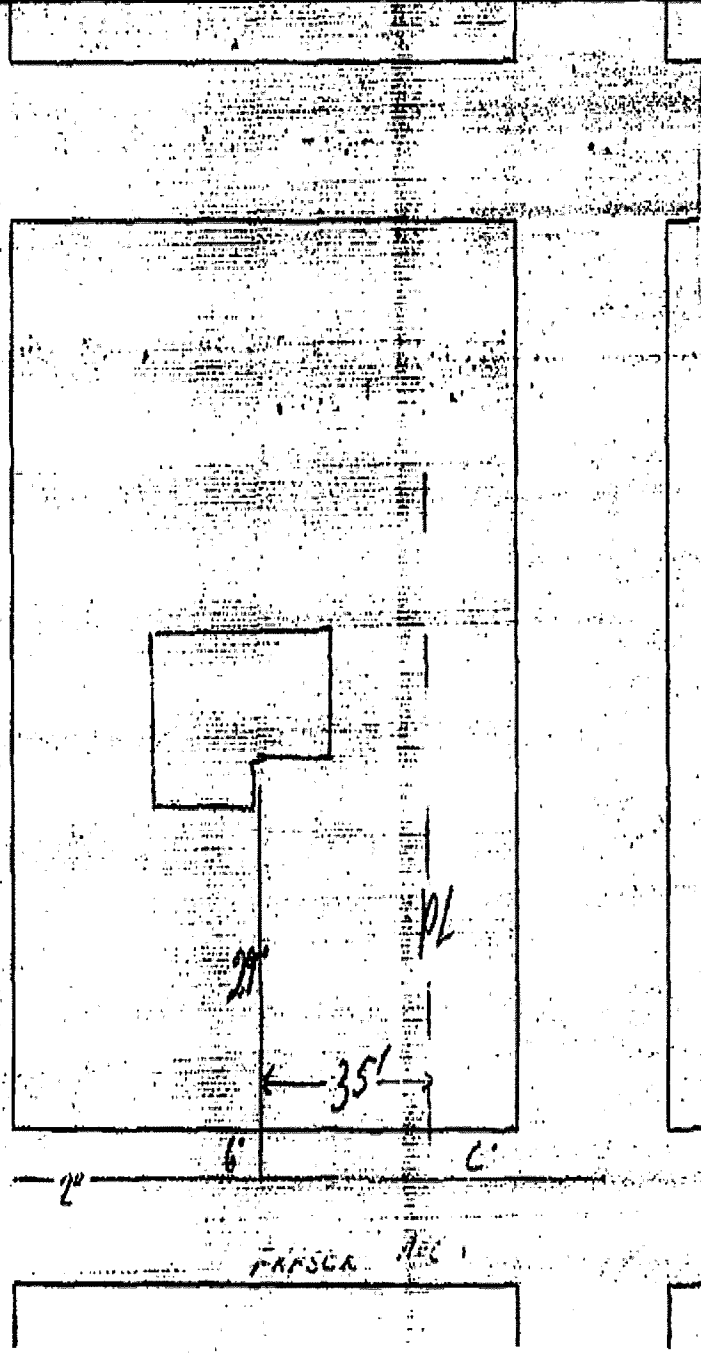

FANSON REC

FORSTS BC GAS
GAS SERVICE ABANDONMENT
9518 BROADWAY ST

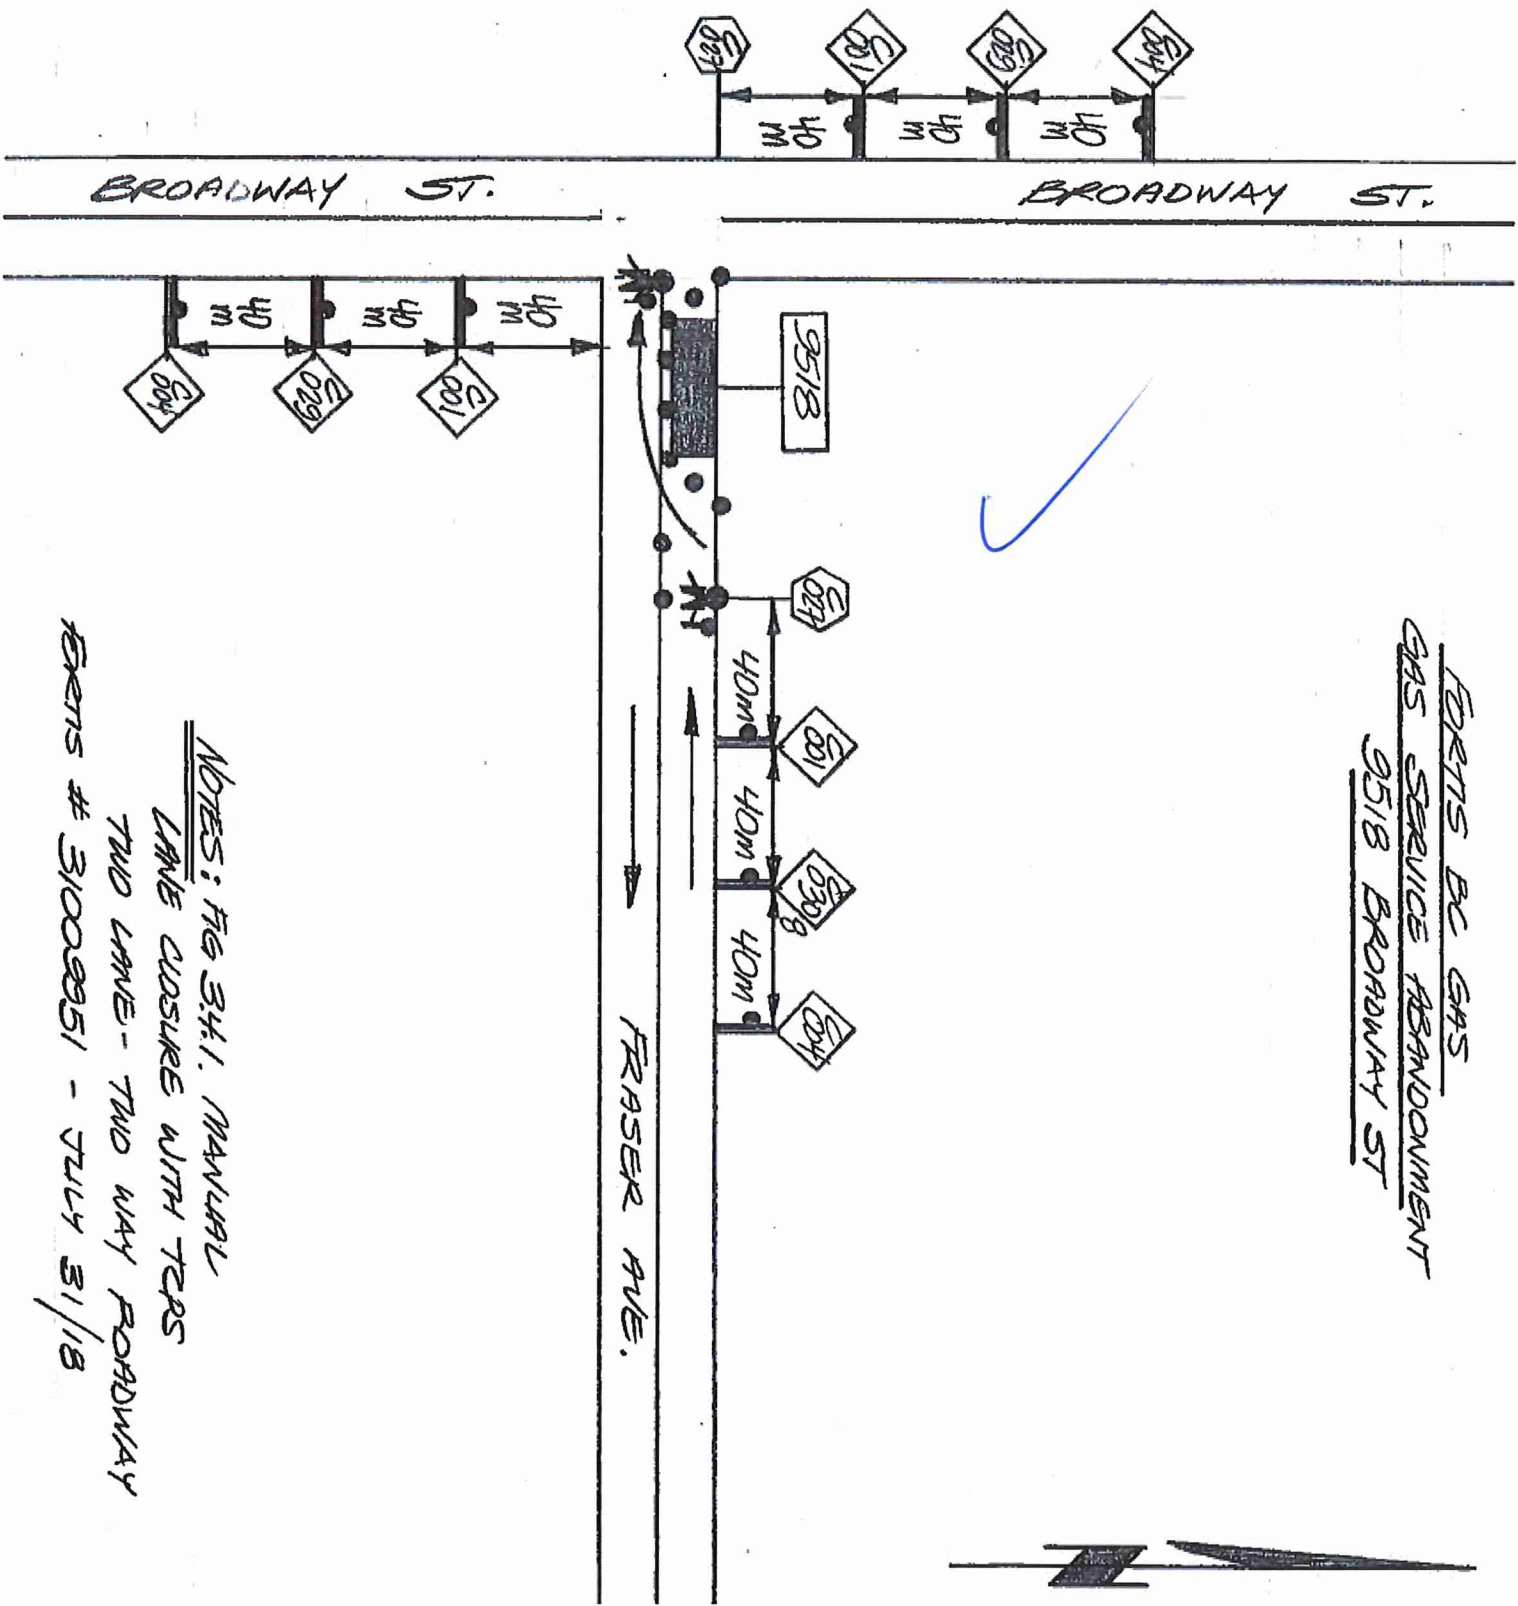

NOTES: FIG 34.1. MANUAL
LANE CLOSURE WITH TRPS
TWO LANES - TWO WAY ROADWAY
PERMS # 31009951 - JULY 31/18