

4110305779



Nearest Intersection: Princess Ave and Stanley St.
Distance from lot to intersection is 41 meters (Due East).
View Scale: 1:1000

9453 Stanley St, Chilliwack

Order #: 31015700 Prem #: 293235 City Limits: Chilliwack

X: 1294362102.00 Y: 470342823.00

Select autotext type 2018/07/30

ATTENTION: DO NOT RELY ON THIS INFORMATION ALONE. You must manually dig to locate gas lines before using excavation machinery. All locations are shown approximate only & gas lines built after the date below are not in this information package. FortisBC will not accept responsibility for errors or omissions. Depth of gas line are not available due to possible change of grade.


UNIT # _____ HOUSE # 9453 ST. NO. _____ ST. NAME Stanley St (3) SUFFIX _____ MISC. CRK TRANS TRUNK
 ADDRESS SERVED _____ HIGH MED. LOW
 MEN SERIES _____ MAT. ST. CI. PL. PE.
 FROM SIZE 1" OFFSET 1.2 m FROM S SIDE OF PRINCESS AVE DEPTH 1.0 m
 SERVICE SIZE 1/2" LOC. 11.2 m OFF. F FROM NW COR. OF WEST P/L DIST. TO HPSC MAT. ST. PL. PE.
 VAL. PIPE 3/16"
 CURB COCK YES LOC. _____ CASR. YES LOC. _____ MA. SIZE 1" BELG. ENTRY INSIDE METER

SERVICE PIPE ISOLATED AT VALV PL.
 LENGTH 1.2M SIZE 1/2" TEST & TRANS.
 VALV. 8.2M GENERAL PART CORR.
 LOG _____ RE-TAPPED UGR.
 WAT. _____ OLD SERVICE CUTOFF YES NO
 AT MAIN OTHER _____
 OLD PIPE REMOVED YES NO
 P.P. ASSE. ISTR. _____ SIZE _____
 METERS: _____
 READER: _____
 READING: _____

UGR. _____ MA. SIZE _____ SLATER
 CASING _____ POSTS _____
 PAVEMENT: SAVED SCHEMATIC _____ PAVEMENT _____
 PAVE. CUT _____
 NO. OF CUTS _____ THICKNESS _____ CALLED YES NO
 METER NO. R42 47589
 READING 0

INSPECTION REPORT I HEREBY CERTIFY THAT THE PIPING WAS INSTALLED IN ACCORDANCE WITH AUTHORITY STANDARD PRACTICES AND WAS EXAMINED IN AN ATTEST OF 700 m
 FOR 12 METERS AND THAT NO LEAKAGE WAS INDICATED
 FOREMAN D.R. GIBSON DATE 9/08/12
 I/METERED YES NO BY CONTRACTOR

PROB. DEPTH CERT. BY SPVR. _____ m DATA _____
 SUPERVISOR [Signature]

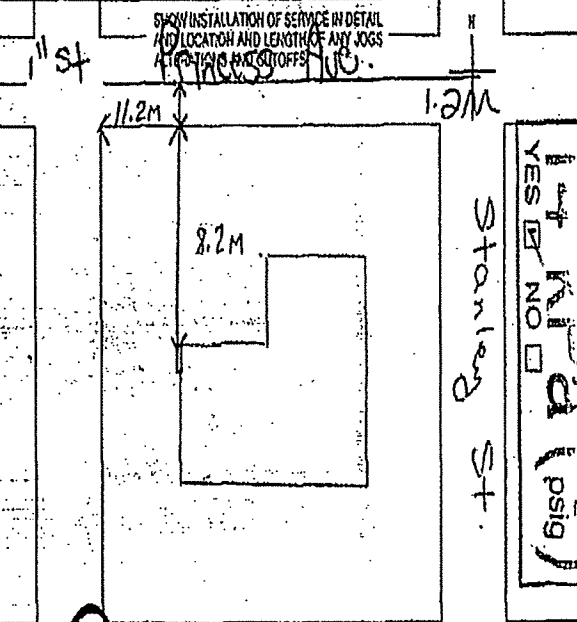

NOTICE TO CONTRACTORS: D.C. HYDRO & POWER AUTHORITY DOES NOT ACCEPT ANY RESPONSIBILITY FOR ERRORS OR OMISSIONS IN THE LOCATIONS SHOWN FOR EXISTING UNDERGROUND UTILITIES AND STRUCTURES. ALL SUCH LOCATIONS SHOWN ARE APPROXIMATE ONLY AND MUST BE CONFIRMED BY THE USE OF PIPE LOCATOR AND MANUAL DIGGING.
 P.E. 570

COSTING

1st Aid (psig)