


# 4110305694

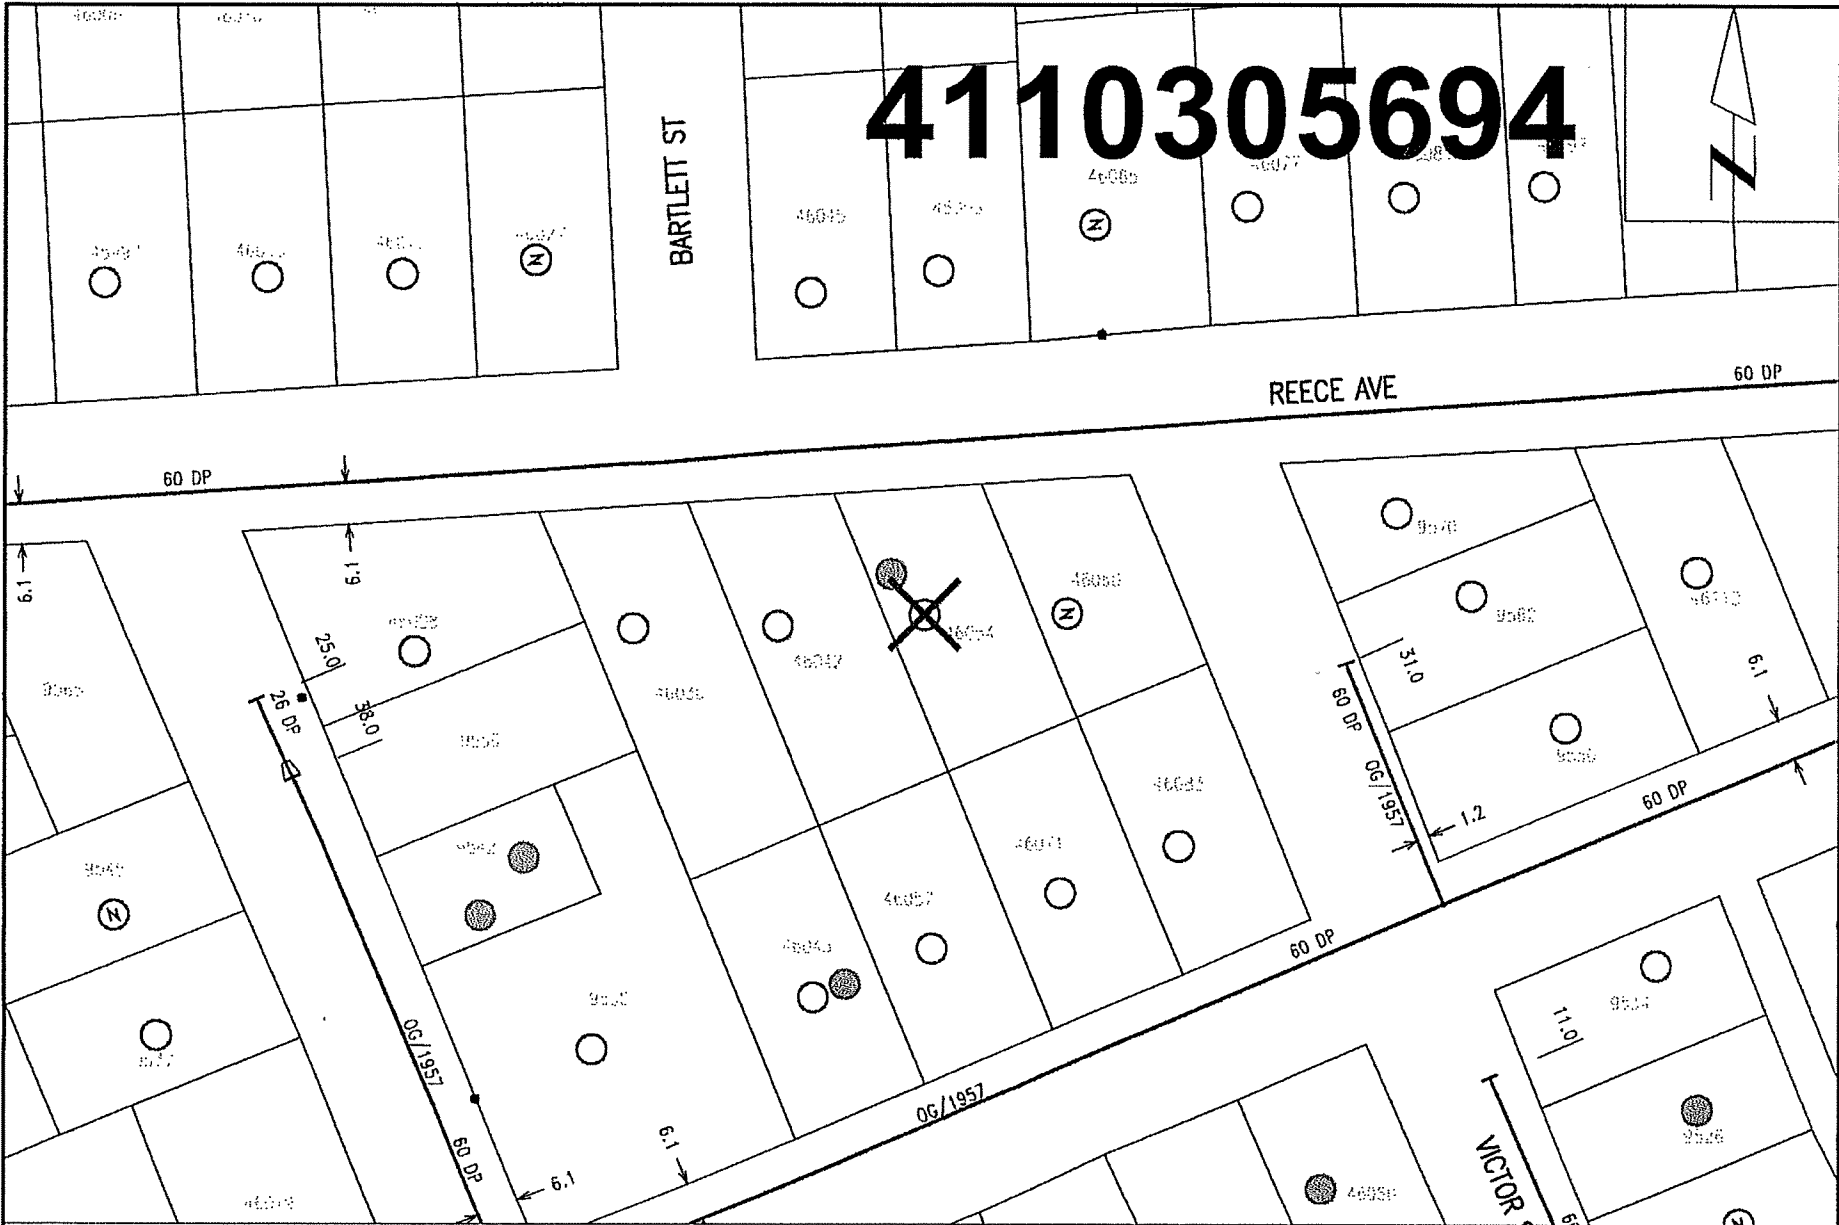

**Nearest Intersection: Bartlett St and Reece Ave.**  
Distance from lot to intersection is 42 meters (54 degrees West of North).  
View Scale: 1:1000

**46054 Reece Ave, Chilliwack**  
Order #: 31015824 Prem #: 290934 City Limits: Chilliwack  
X: 1295428180.00 Y: 470624960.00 Select autotext type 2018/07/30

ATTENTION: DO NOT RELY ON THIS INFORMATION ALONE. You must manually dig to locate gas lines before using excavation machinery. All locations are shown approximate only & gas lines built after the date below are not in this information package. ForisBC will not accept responsibility for errors or omissions. Depth of gas line are not available due to possible change of grade.

① 46054 ①

ADDRESS SERVED: Reece Ave E DISTRICT: CHILLIWACK TYPE OF PREMISES: S.F.D.

TRUNK  HIGH  LOW

SIZE: 1/2" LOCATED 27" FT. E FROM NW CORNER OF NR

SERVED OFF 2" MAIN ON REECE AVE. E. STEEL  CAST  GALV.  DEPTH 3'

MAIN CORROSION: YES  NO  DEPTH PITS: \_\_\_\_\_ CLASS: 2  3  4  5  6

TYPE OF COATING: TAR GOOD  DAMAGED  POOR  NIL

SERVICE PIPE	MATERIAL
MAIN TO P/L <u>20'</u>	KIT NO. _____
P/L TO BLDG. <u>3.3'</u>	INCLUDES CURB COCK YES <input type="checkbox"/> NO <input checked="" type="checkbox"/>
EXTENDED _____	INCLUDES SHUT OFF TEE YES <input type="checkbox"/> NO <input checked="" type="checkbox"/>
RISER <u>3'</u>	
TOTAL: <u>5.6'</u>	
RENEWAL: COMPLETE <input type="checkbox"/> PARTIAL <input type="checkbox"/>	
OLD SERVICE CUT OFF: YES <input type="checkbox"/> NO <input checked="" type="checkbox"/>	
CUT AT MAIN <input type="checkbox"/> OTHER _____	
SEE C.U.O. _____ FOR CUT OFF.	
METER NUMBERS <u>H.C. 21050</u>	
INSTALLED <input checked="" type="checkbox"/> REMOVED <input type="checkbox"/> OUTSIDE <input type="checkbox"/> INSIDE <input type="checkbox"/>	

INSPECTION REPORT: I HEREBY CERTIFY THAT THE PIPING WAS INSTALLED IN ACCORDANCE WITH AUTHORITY STANDARD PRACTICES AND WAS EXAMINED UNDER AN AIR TEST OF 100 P.S.I.G. FOR 5 MINS. AND THAT NO LEAKAGE WAS INDICATED.

DATE: Sept 7/21

CAHO S/F MAN: [Signature]

FURTHER WORK REQUIRED AT THIS LOCATION: YES  NO  EXPLAIN: HOT PATCH

REQ. BELLHOLE IN BACKYD 4'x4'

SUPERVISOR: [Signature]

YOUNG RD.

REECE AVE. E. 2"

SHOW MAIN LOCATION AS FOUND.